

**TOWN OF ORFORD, NH
TOWN ROAD 100 BRIDGE REPLACEMENT
OVER ARCHERTOWN BROOK
D&K Project No. 624237**

ADDENDUM NO. 1

July 31, 2020

Page 1 of 1

TO: PROSPECTIVE BIDDERS

FROM: DuBois & King, Inc.
831 Union Avenue, Suite 2
Laconia, NH 03246

This Addendum forms part of the Contract Documents and modifies the original Bidding Documents dated July 6, 2020. **NOTE: Contractor to Acknowledge receipt of this Addendum in the space provided on Page 1 of the Bid Form (Section 00410, Page 00410-1). Failure to do so may subject the Bidder to disqualification.**

I. CONTRACT DOCUMENTS (SPECIFICATIONS) CHANGES

A. SECTION 111 – ADVERTISEMENT FOR BIDS

Revise the first paragraph, 3rd line by changing the Bid Opening date to August 11, 2020 and revise the line as follows:

“... 03777, until 4:00 PM local time on, **Tuesday, August 11, 2020**, at which time the Bids received will be publicly opened and read.”

Revise the fifth paragraph by changing the Start Date to August 17, 2020 and the Completion Date to December 11, 2020 and revise the paragraph as follows:

“The anticipated project schedule is to start construction on or about **August 17, 2020** and complete construction by **December 11, 2020**. The NHDES permit is still pending, but in-stream work restrictions have been removed from the permit requirements.”


II. ATTACHMENTS

- Temporary Bridge Plan sheet
Revised Temporary Bridge Width, Rev. 7/31/2020

END ADDENDUM

SDR PROCESSED	NAME1	DATE	DATE1	DATE	DATE2	DATE	DATE3	DATE
NEW DESIGN	NAME2	DATE	DATE2	DATE	DATE2	DATE	DATE3	DATE
SHEET CHECKED	NAME3	DATE	DATE3	DATE	DATE3	DATE	DATE3	DATE
AS BUILT DETAILS		DATE		DATE		DATE		DATE

REVISIONS AFTER PROPOSAL	DESCRIPTION	STATION
1	REVISED TEMPORARY BRIDGE WIDTH	

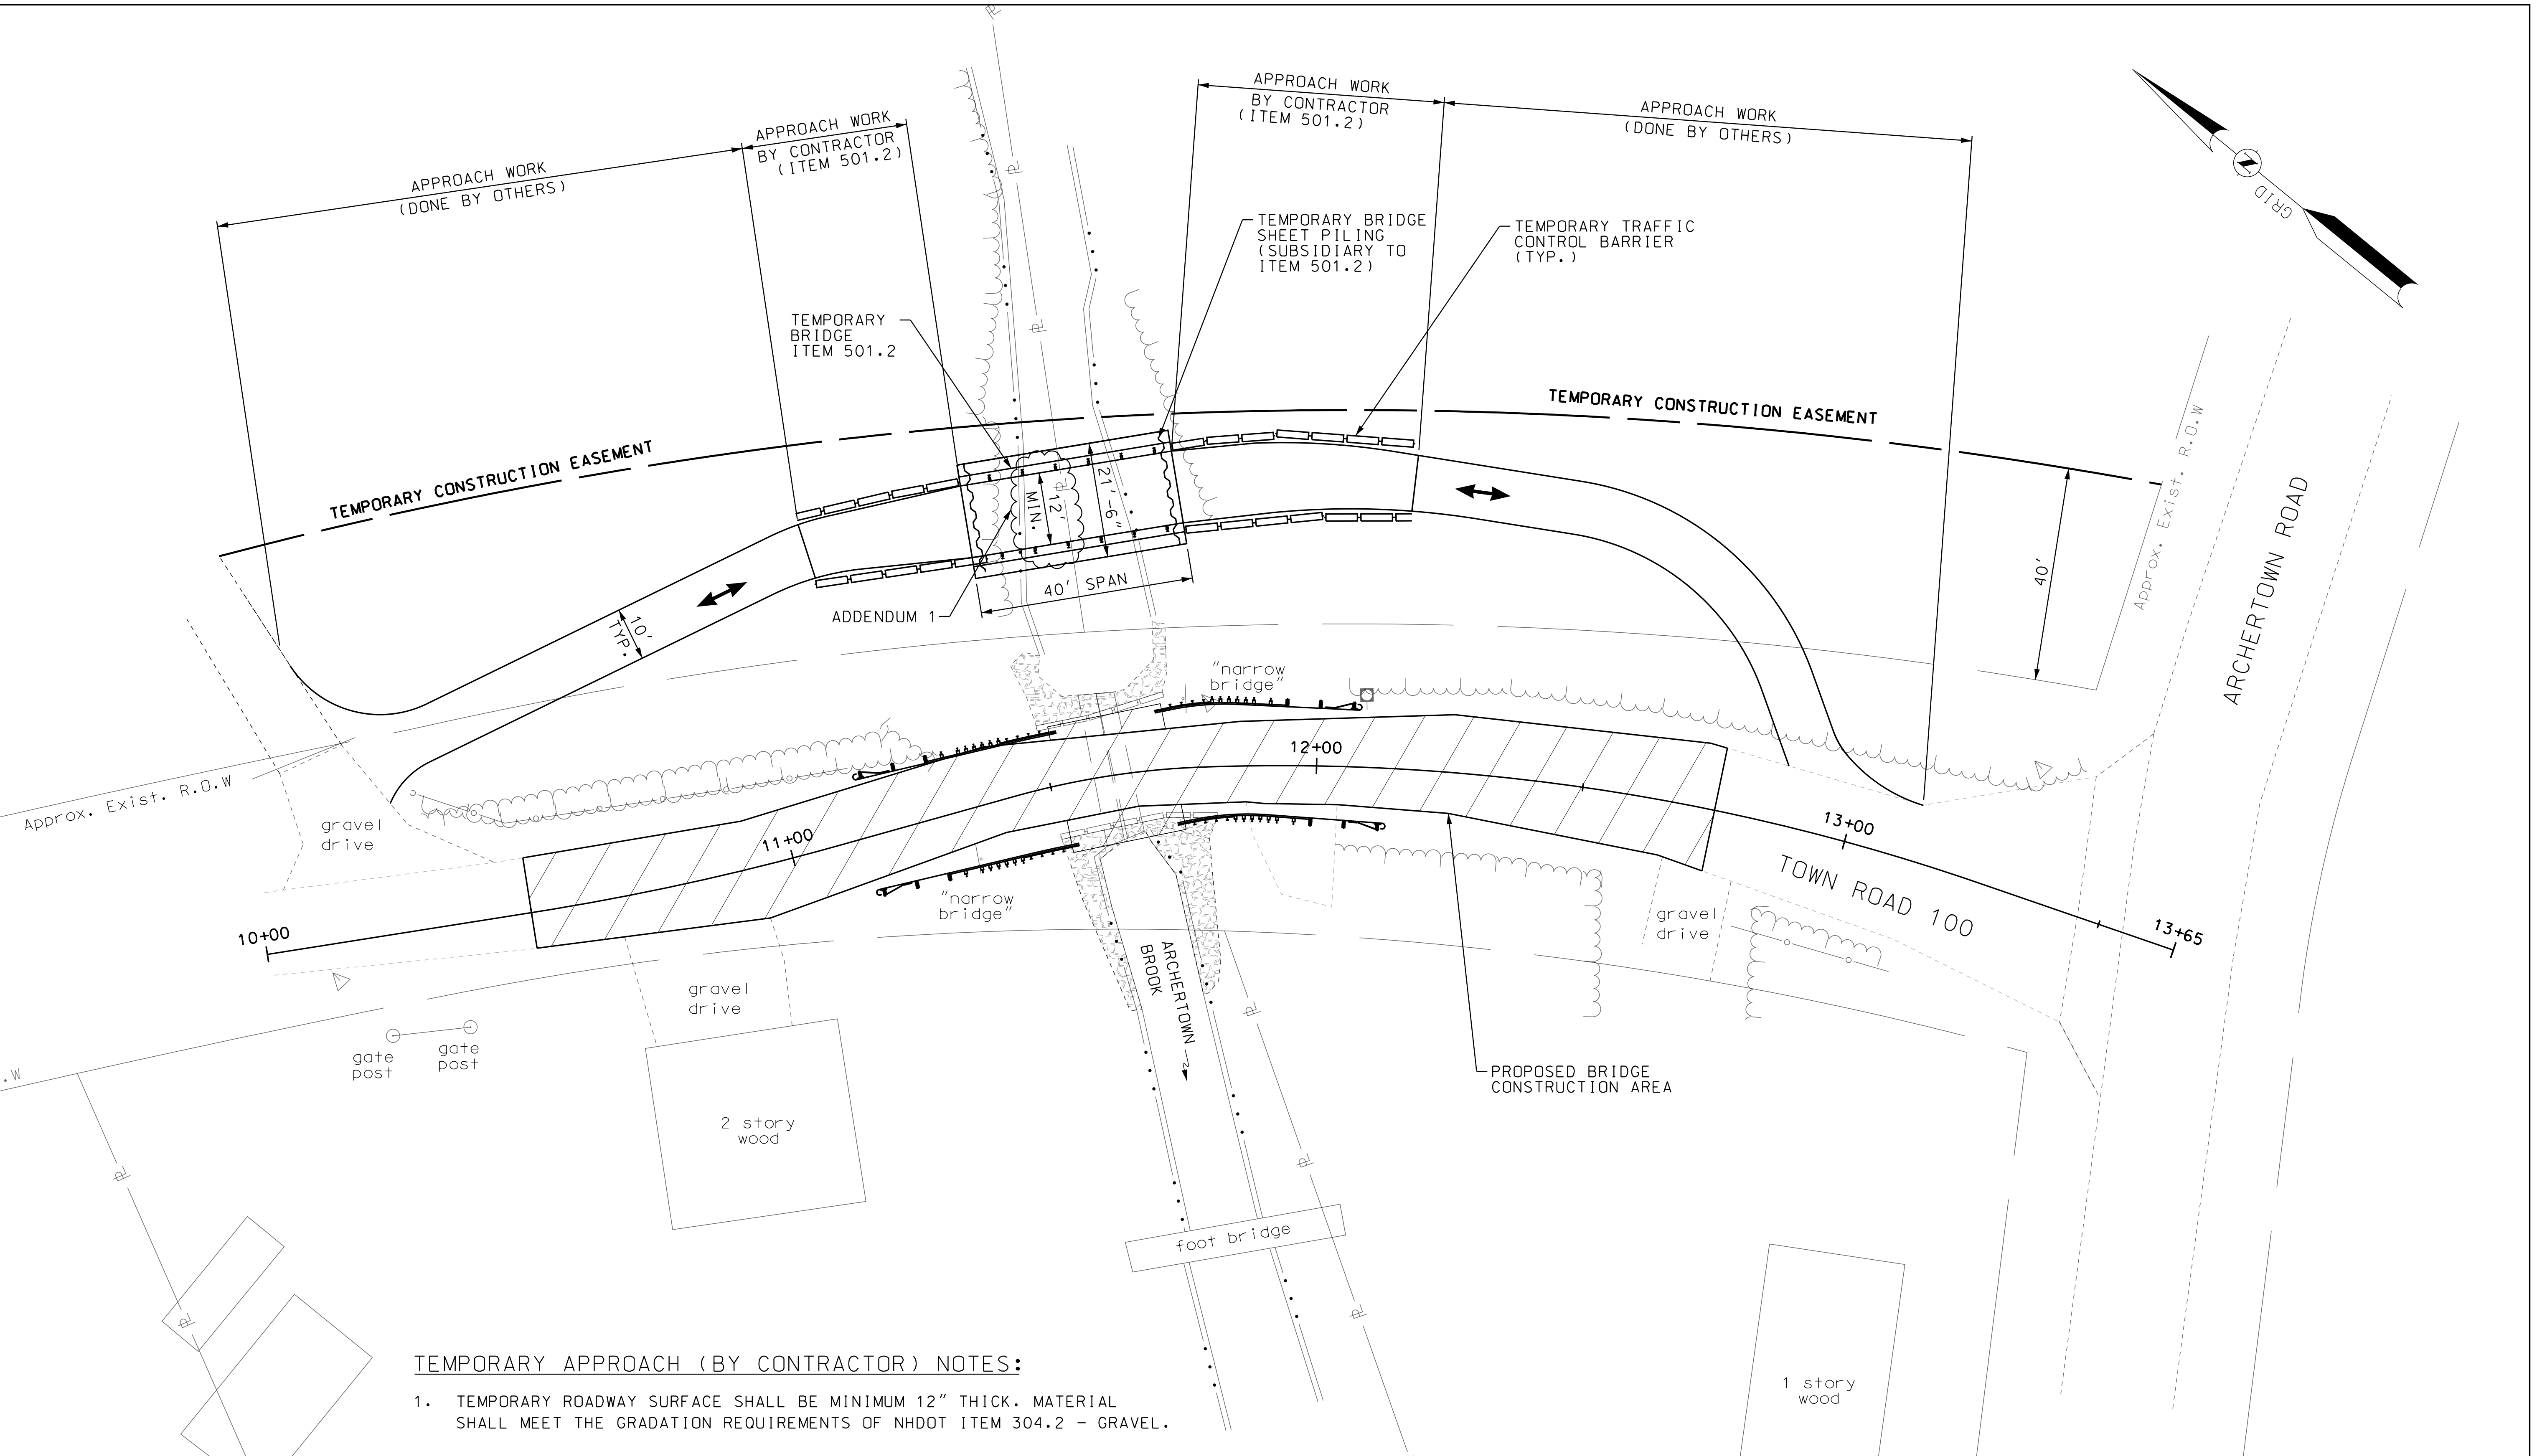

TEMPORARY APPROACH (BY CONTRACTOR) NOTES:

1. TEMPORARY ROADWAY SURFACE SHALL BE MINIMUM 12" THICK. MATERIAL SHALL MEET THE GRADATION REQUIREMENTS OF NHDOT ITEM 304.2 - GRAVEL.
2. ALL COSTS ASSOCIATED WITH THE APPROACHES FOR THE TEMPORARY DIVERSION (BY CONTRACTOR) SHALL BE INCIDENTAL TO ITEM 501.2.

TOWN OF ORFORD, NEW HAMPSHIRE			
TEMPORARY BRIDGE PLAN			
DGN	STATE PROJECT NO.	SHEET NO.	TOTAL SHEETS
Temp Bridge		\$\$#	