

**BBCO Wastewater Pretreatment
25 Omega Dr.
Williston, VT 05403
D&K Project No. 530759
ADDENDUM NO. 1**

February 11, 2026

Page 1 of 2

TO: PROSPECTIVE BIDDERS

**FROM: DuBois & King, Inc.
6 Green Tree Dr.
South Burlington, VT 05403**

This Addendum forms part of the Contract Documents and modifies the original Bidding Documents dated January 30, 2026. **NOTE: Contractor to Acknowledge receipt of this Addendum in the space provided on Page 1 of the Bid Form. Failure to do so may subject the Bidder to disqualification.**

I. CONTRACT DOCUMENTS (SPECIFICATIONS) CHANGES

A. No Changes

II. PLANS (DRAWINGS) CHANGES

A. Refer to attached revised sheets:

1. P0.1 – PLUMBING LEGEND AND GENERAL NOTES
2. E0.1 – LEGENDS AND NOTES
3. E1.1 – FIRST FLOOR PLAN – POWER
4. E6.1 – ELECTRICAL SCHEDULES & DETAILS

III. ADDITIONAL INFORMATION OR CLARIFICATION

Note that some questions are paraphrased based on emails received to date:

1. Regarding tanks TK301 and TK202. There is tank orientation conflicts between drawings C3 and E1.1. which is correct?

Response: C3 is correct. Refer to attached revised sheet E1.1.

2. Sump pump schedule on drawing P0.1 indicates three phase, while schedule on drawing E1.1 and panel schedule on drawing E6.1 indicates single phase. Which is correct?

Response: SP-1 to be three phase. Refer to attached revised E1.1 and E6.1.

3. Drawing E1.1, Who is supplying the 150amp ATS? There's no notes or specs on this item.

Response: Contractor to supply ATS. Refer to attached revised E6.1.

4. Do we assume panel NP1 feeder is wired thru the ATS. Drawings do not indicate.

Response: Yes, refer to attached revised E6.1.

5. Drawing E1.1, keynote 15. Is this a one cable drop to each jack?

Response: Refer to attached revised E0.1.

6. What is the size of the interior pump station?

Response: Provide sump pump with 4'Ø x 6' deep precast concrete sump. Refer to attached revised sheet P0.1.

7. How many pumps are included in the interior pump station?

Response: One sump pump, SP-1, is to be provided by the contractor in this project.

IV. ATTACHMENTS

A. REVISED PLUMBING AND ELECTRICAL SHEETS:

- I. P0.1 – PLUMBING LEGEND AND GENERAL NOTES
- II. E0.1 – LEGENDS AND NOTES
- III. E1.1 – FIRST FLOOR PLAN – POWER
- IV. E6.1 – ELECTRICAL SCHEDULES & DETAILS

END OF ADENDUM

© Copyright 2026 DuBois & King Inc.

ISSUED FOR BID
NOT FOR CONSTRUCTION
01/30/2026

ELECTRICAL LEGENDS & ABBREVIATIONS	
NOTE: NOT ALL SYMBOLS/ABBREVIATIONS SHOWN IN THE LEGEND ARE USED IN THIS DRAWING SET. IT IS THE CONTRACTOR'S RESPONSIBILITY TO VERIFY CONTENT SHOWN ON DRAWINGS.	
DRAWING NOTATIONS	ABBREVIATIONS
DEMO LINE	Ø PHASE
EXISTING LINE	A AMPERE(S)
NEW LINE	A.C. ALTERNATING CURRENT
REVISION CLOUD WITH REVISION NUMBER	AF AMPERE-FARAD
NOTES WHEN SIMILAR TO SECTION	AFF ABOVE FINISH FLOOR
DETAIL NUMBER	AGF ABOVE GROUND FINISH GRADE
DRAWING NUMBER	AL ALUMINUM
SECTION LETTER	ALT ALTERNATE
SHEET NUMBER WHERE SECTION	ARCH ARCHITECT(URAL)
VIEW IS SHOWN	AT AMP TRIP
POWER	ATC AUTOMATIC TEMPERATURE CONTROL
GFCI DUPLEX RECEPTACLE	ATS AUTOMATIC TRANSFER SWITCH
GFCI WEATHER RESISTANT DUPLEX RECEPTACLE WITH WATERPROOF IN-USE COVER	AWG AMERICAN WIRE GAUGE
DUPLEX RECEPTACLE WITH TYPE-A AND TYPE-C USB	BAS BUILDING AUTOMATION SYSTEM
DUPLEX RECEPTACLE ON EMERGENCY CIRCUIT, DEVICE SHALL BE RED WITH RED DEVICE PLATE	BW BUSWAY
DUPLEX RECEPTACLE FOR FIXED MICROWAVE, COORDINATE EXACT LOCATION WITH ES	C CONDUIT
DUPLEX RECEPTACLE FOR FIXED DISHWASHER, COORDINATE EXACT LOCATION WITH ES	CATV CABLE ACCESS TELEVISION
SPLIT WIRED DUPLEX RECEPTACLE, TOP SWITCHED	CB CIRCUIT BREAKER
AUTOMATICALLY CONTROLLED DUPLEX RECEPTACLE, TOP CONTROLLED WITH NEC REQUIRED MARKING	CKT CIRCUIT
COUNTERTOP HEIGHT DUPLEX RECEPTACLE, 20A, 120V	CLG CEILING
QUADRUPLEX RECEPTACLE, 20A, 120V	CM CONSTRUCTION MANAGER
COUNTERTOP HEIGHT QUADRUPLEX RECEPTACLE, 20A, 120V	COND CONDUCTOR
CEILING MOUNTED DUPLEX RECEPTACLE	CONN CONNECT
SPECIAL PURPOSE RECEPTACLE, REFER TO SCHEDULE.	CT CURRENT TRANSFORMER
EQUIPMENT SERVICE SWITCH	CU COPPER
MOTOR STARTER, PROVIDED BY MC, INSTALLED BY EC.	D.C. DIRECT CURRENT
VARIABLE FREQUENCY DRIVE, PROVIDED BY MC, INSTALLED BY EC.	DISC DISCONNECT
JUNCTION BOX	DN DOWN
ELECTRIC MOTOR	DP DOUBLE POLE
FLOOR BOX	DT DOUBLE THROW
ELECTRICAL DISTRIBUTION	DWG DRAWING
ELECTRICAL DISTRIBUTION PANEL	<> EXISTING
HEAVY DUTY FUSED DISCONNECT, 600V	EC ELECTRICAL CONTRACTOR
DRY TYPE TRANSFORMER	E HTR ELECTRIC HEATER
SWBD DISTRIBUTION SWITCHBOARD, REFER TO ONE-LINE DIAGRAM	EM EMERGENCY
MTS MANUAL TRANSFER SWITCH	EMT ELECTRICAL METALLIC TUBING
COMMUNICATION	EOL END OF LINE RESISTOR
FLUSH MOUNTED 2-PORT CAT.6 WALL JACK WITH (2) CAT. 6 HOMERUNS TO NETWORK TERMINATION AREA	ES EQUIPMENT SUPPLIER
R	F FUSE
REC RECEP	FA FIRE ALARM
RMC RIGID METAL CONDUIT	FACP FIRE ALARM CONTROL PANEL
SEC SECONDARY	FDR FEEDER
SF SINGLE THROW	FL FLOR
SW SWITCH	FS FUSEABLE SWITCH
SWBD SWITCHBOARD	FT FEET
TEL TELEPHONE	FPC FIRE PROTECTION CONTRACTOR
TEMP TEMPORARY	<> DEMOLISH
TV TELEVISION	GC GENERAL CONTRACTOR
TYP TYPICAL	GFCI GROUND FAULT CIRCUIT INTERRUPTER
UC UNDERCABINET	GFP GROUND FAULT PROTECTION
UG UNDERGROUND	GND GROUND
UH UNDER HEATER	HOA HAND-OFF-AUTOMATIC
UN UNLISTED	HP HIGH-POWER
UON UNLISTED OTHERWISE NOTED	HZ FREQUENCY IN CYCLES PER SECOND
UPS UNINTERRUPTED POWER SYSTEM	IMC INTERMEDIATE METALLIC CONDUIT
V VOLTS	in INCHES
VA VOLT AMPERE(S)	JB JUNCTION BOX
VAR REACTIVE VOLT AMPERE(S)	K KEY OPERATED
VP VAPORPROOF	KCML THOUSAND CIRCULAR MIL(S)
VFD VARIABLE FREQUENCY DRIVE	KVA KILOVOLT AMPERE(S)
VIF VERIFY IN FIELD	KVAR KILOVAR(S)
W WATT(S)	KW KILOWATT(S)
WP WEATHERPROOF	LF LINEAR FEET
XFM TRANSFORMER	LV LOW VOLTAGE
XP EXPLOSION PROOF	MC MECHANICAL CONTRACTOR
MCB MECHANICAL CIRCUIT BREAKER	MCB MECHANICAL CIRCUIT BREAKER
MCG MOTOR CONTROL CENTER	MCG MOTOR CONTROL CENTER
MEP MECHANICAL, ELECTRICAL, PLUMBING	MEP MECHANICAL, ELECTRICAL, PLUMBING
MH MANHOLE	MH MANHOLE
MLO MAIN LUGS ONLY	MLO MAIN LUGS ONLY
MTH MOUNTING HEIGHT	MTH MOUNTING HEIGHT
MTR MOTOR	MTR MOTOR
MTS MANUAL TRANSFER SWITCH	MTS MANUAL TRANSFER SWITCH
NC NORMALLY CLOSED	NC NORMALLY CLOSED
NEC NATIONAL ELECTRICAL CODE	NEC NATIONAL ELECTRICAL CODE
NF NONFUSED	NF NOT FUSED
NIC NOT IN CONTRACT	NIC NOT IN CONTRACT
NO NUMBER	NO NUMBER
NTS NOT TO SCALE	NTS NOT TO SCALE
OH OVERHEAD	OH OVERHEAD
P POLE(S)	P POLE(S)
PC PLUMBING CONTRACTOR	PC PLUMBING CONTRACTOR
PNL PANEL	PNL PANEL
PRI PRIMARY	PRI PRIMARY
PT POTENTIAL TRANSFORMER	PT POTENTIAL TRANSFORMER
PVC POLYVINYL CHLORIDE	PVC POLYVINYL CHLORIDE
R RELAY	R RELAY
REC RECEP	R> REMOVE AND RELOCATE
RMC RIGID METAL CONDUIT	REC RECEP
SEC SECONDARY	RMC RIGID METAL CONDUIT
SF SINGLE THROW	SEC SECONDARY
SW SWITCH	SF SINGLE THROW
SWBD SWITCHBOARD	SW SWITCH
TEL TELEPHONE	SWBD SWITCHBOARD
TEMP TEMPORARY	TEL TELEPHONE
TV TELEVISION	TEMP TEMPORARY
TYP TYPICAL	TV TELEVISION
UC UNDERCABINET	TYP TYPICAL
UG UNDERGROUND	UC UNDERCABINET
UH UNDER HEATER	UG UNDERGROUND
UN UNLISTED	UH UNDER HEATER
UPS UNINTERRUPTED POWER SYSTEM	UN UNLISTED
V VOLTS	UPS UNINTERRUPTED POWER SYSTEM
VA VOLT AMPERE(S)	V VOLTS
VAR REACTIVE VOLT AMPERE(S)	VA VOLT AMPERE(S)
VP VAPORPROOF	VAR REACTIVE VOLT AMPERE(S)
VFD VARIABLE FREQUENCY DRIVE	VP VAPORPROOF
VIF VERIFY IN FIELD	VFD VARIABLE FREQUENCY DRIVE
W WATT(S)	VIF VERIFY IN FIELD
WP WEATHERPROOF	W WATT(S)
XFM TRANSFORMER	WP WEATHERPROOF
XP EXPLOSION PROOF	XFM TRANSFORMER

ELECTRICAL GENERAL NOTES

- ALL WORK SHALL CONFORM TO THE NATIONAL ELECTRICAL CODE (N.E.C.) 2023 EDITION. CONTRACTOR TO OBTAIN ALL PERMITS AND ARRANGE FOR ALL INSPECTIONS WITH AUTHORITY HAVING JURISDICTION. ALL WORK SHALL BE IN COMPLIANCE WITH ALL RELEVANT CODES, STANDARDS, AND REGULATIONS. THE CONTRACTOR SHALL BE FAMILAR WITH ALL REQUIRED LOCAL STANDARDS AND CODES. ALL MATERIAL USED SHALL MATCH THE QUALITY OF EXISTING INSTALLATIONS.
- LIMIT 20A, 120V BRANCH CIRCUITS TO A MAXIMUM 1920VA LOAD AND 15A, 120V BRANCH CIRCUIT TO A MAXIMUM 1440VA LOAD.
- ALL WIRING SHALL BE CONCEALED IN WALLS AND ABOVE CEILING IN FINISHED AREAS AND WHEREVER POSSIBLE. WIRING IN UTILITY AREAS (MECHANICAL SPACE) MAY BE RUN EXPOSED AS APPROVED BY THE ARCHITECT. EXPOSED WIRING SHALL BE IN CONDUIT, BE PARALLEL TO BUILDING STRUCTURAL ELEMENTS AND PRESENT A NEAT AND COMPLETE INSTALLATION.
- WHERE WIRING CAN NOT BE ROUTED CONCEALED UTILIZE WIREMOLD SURFACE RACEWAY (WITH ALL NECESSARY FITTINGS/HARDWARE AND ATTACHMENT) WITH STRANDED TYPE THHN/THWN CONDUCTOR. ALL COMPONENTS SHALL BE PAINTED AS DIRECT BY ENGINEER. COORDINATE MOUNTING WITH ARCHITECT.
- CONDUITS, RACEWAYS AND CABLES SHALL BE PROPERLY AND SECURELY ATTACHED TO BUILDING STRUCTURAL COMPONENTS AS REQUIRED BY N.E.C. ALL FASTENERS AND HARDWARE SHALL BE APPROVED FOR THE INSTALLATION AND THE CONDITIONS ENCOUNTERED.
- EACH OUTLET OR JUNCTION IN ANY OF THE WIRING SYSTEMS SHALL BE MADE IN AN APPROVED, METALLIC JUNCTION BOX. SUCH BOX SHALL BE SUITABLE FOR THE SIZE AND NUMBER OF CONDUCTORS AND DEVICES TO BE INSTALLED, AS WELL AS THE CONDITION ENCOUNTERED. ALL SPLICES SHALL BE MADE WITH APPROVED, MECHANICAL CONNECTORS.
- VERIFY ALL STRUCTURAL, ARCHITECTURAL AND MECHANICAL CONDITIONS (DUCT CLEARANCES, COUNTER HEIGHTS, DOOR SWINGS, ETC.) PRIOR TO ROUGH IN FOR ELECTRICAL WIRING EQUIPMENT.
- ALL ELECTRICAL WORK SHALL BE CAREFULLY COORDINATED WITH THE WORK OF OTHER TRADES AND ON-SITE CONDITIONS. WHERE CUTTING, DRILLING OR ALTERATION TO THE WORK OF OTHERS IS NECESSARY, FOR THE PROPER INSTALLATION OF ELECTRICAL EQUIPMENT, SUCH WORK SHALL BE PLANNED IN ADVANCE WITH THE GENERAL CONTRACTOR AND SHALL BE CAREFULLY DONE. ANY DAMAGE TO THE BUILDING OR EQUIPMENT SHALL BE REPAIRED BY PROPERLY TRAINED PERSONNEL, TO THE SATISFACTION OF THE ARCHITECT, AT NO ADDITIONAL COST TO THE OWNER.
- DURING ROUGH IN AND FINISHED STAGES OF CONSTRUCTION, PROTECT AND KEEP CLEAN ALL ELECTRICAL EQUIPMENT, PANELS, FIXTURES AND DEVICES.
- PROVIDE ALL INFORMATION ABOUT EQUIPMENT WHICH IS BEING FURNISHED TO THE GENERAL CONTRACTOR FOR COORDINATION PURPOSES. PROVIDE ALL INSTALLATION DETAILS AND SUPPORT COMPONENTS TO THE GENERAL CONTRACTOR SO THAT THESE MAY BE BUILT INTO THE CONSTRUCTION IN A TIMELY MANNER.
- VERIFY LOCATIONS OF MECHANICAL, HVAC AND OWNER'S EQUIPMENT AND POWER CONNECTION DETAILS SO THAT THE ASSOCIATED ELECTRICAL WORK WILL BE PROPERLY COORDINATED AND INSTALLED.
- PROVIDE EACH MECHANICAL FAN, PUMP OR HVAC UNIT WITH FUSED DISCONNECT, WEATHERPROOF NEMA 3R&12 (WP) FOR OUTDOOR, NEMA 1 FOR INDOOR. FUSE TO MATCH EQUIPMENT NAMEPLATE OF EQUIPMENT.
- THE ARCHITECT RESERVES THE RIGHT TO RELOCATE ANY LIGHTING FIXTURE SHOWN TO WITHIN FIVE (5) FEET OF THAT LOCATION AS TO WORK WITH FINAL FIT-UP REQUIREMENTS. COORDINATE ALL SWITCHES, RECEPTACLE AND LIGHTING FIXTURE LOCATIONS WITH THE ARCHITECT.
- THE ELECTRICAL CONTRACTOR SHALL COORDINATE EXACT LOCATIONS AND MOUNTING HEIGHTS FOR ALL WALL-MOUNTED LIGHTING FIXTURES (INCLUDING FIXTURES IN STAIRWELLS) WITH ARCHITECTURAL INTERIOR ELEVATIONS, SECTIONS, AND DETAILS PRIOR TO ROUGH-IN.
- ALL MECHANICAL EQUIPMENT SHALL HAVE HACR RATED BREAKERS PER N.E.C. REQUIREMENTS.
- ALL EXIT SIGNS, STAIRWELL LIGHTING FIXTURES, AND EMERGENCY EGRESS LIGHTS SHALL BE NON-SWITCHED, ALWAYS ON, UNLESS OTHERWISE NOTED.
- VERIFY THE CONDITION OF BRANCH CIRCUIT WIRING INDICATED TO BE REUSED. IF WIRING IS FOUND TO BE IN POOR CONDITION, REPLACE WITH TYPE THHN/THWN COPPER CONDUCTORS OF ADEQUATE SIZE.
- THE INTERIOR ELECTRICAL SYSTEM SHALL BE COMPLETELY AND EFFECTIVELY GROUNDED AS REQUIRED BY THE NEC. ALL METALLIC RACEWAYS SHALL BE MECHANICALLY AND ELECTRICALLY SECURE AT ALL JOINTS AND AT ALL BOXES, CABINETS, FITTINGS, AND EQUIPMENT.
- UPON COMPLETION OF WORK CORRECT ALL PANELBOARD CIRCUIT DIRECTORY CARDS TO REFLECT AS-BUILT CONDITIONS. ALL CIRCUIT DIRECTORY CARDS SHALL BE TYPE WRITTEN.
- ALL RACEWAYS SHALL BE PROVIDED WITH EQUIPMENT GROUND CONDUCTOR. EQUIPMENT GROUND CONDUCTOR SHALL BE INSTALLED IN ALL ELECTRICAL RACEWAYS AND SHALL BE SPECIFIED IN ACCORDANCE WITH NEC 250 AND SHALL BE CONTINUOUS.
- CLEARLY IDENTIFY ALL INCOMING CONDUCTOR BY CIRCUIT NUMBER DURING INSTALLATION IN THE DISTRIBUTION PANELS (E.G. CABLE MARKERS #1, #1 ETC).
- LOCATION OF ALL OUTLETS SHOWN ON DRAWINGS IS APPROXIMATE. CHECK ALL MEASUREMENTS AND VERIFY EXACT LOCATION WITH ARCHITECT.
- ALL MOTOR STARTERS AND VFD'S SHALL BE PROVIDED BY MC, INSTALLED & WIRED BY EC. ALL DISCONNECT AND SAFETY SWITCHES SHALL BE PROVIDED, INSTALLED, AND WIRED BY EC. EC SHALL PROVIDE ALL FUSING, COORDINATE FUSING WITH MC.
- FURNISH, INSTALL, TEST, CALIBRATE, AND OTHERWISE MAKE OPERATIONAL ALL DEVICES AND EQUIPMENT SHOWN ON THESE DRAWINGS.
- IT IS THE INTENT OF DRAWINGS AND SPECIFICATION, TO OBTAIN A COMPLETE AND SATISFACTORY INSTALLATION. AN ATTEMPT HAS BEEN MADE TO SEPARATE AND DEFINE THE WORK OF THE CONTRACTOR. DRAWINGS ARE DIAGRAMMATIC, BUT SHALL BE FOLLOWED AS CLOSELY AS ACTUAL CONSTRUCTION OF THE FACILITY AND THE WORK OF OTHER TRADES WILL PERMIT. THE DRAWINGS UTILIZE SYMBOLS AND SCHEMATIC DIAGRAMS TO INDICATE VARIOUS ITEMS OF WORK. THEREFORE, NO INTERPRETATION WILL BE MADE FROM THE LIMITATION OF SYMBOLS AND DIAGRAMS THAT ANY ELEMENTS NECESSARY OF THE COMPLETE INSTALLATION IS EXCLUDING. THE ENGINEER SHOULD BE NOTIFIED OF ANY DISCREPANCIES, OMISSIONS, CONFLICTS, OR INTERFERENCE WHICH OCCUR BETWEEN VARIOUS DRAWINGS AND SPECIFICATIONS. IF SUCH NOTIFICATION IS NOT RECEIVED, THE INSTALLING CONTRACTOR(S) SHALL BE RESPONSIBLE FOR THEIR INTERPRETATIONS.

CLIENT NAME:
BURLINGTON BEER COMPANY

PROJECT NAME:
BBCO
Wastewater
Pretreatment

25 OMEGA DRIVE
WILLISTON, VT 05495

SHEET TITLE:

LEGENDS & NOTES

D&K PROJECT # PROJ. ENG.
530759 SMP

CHECKED BY DRAWN BY
SMP JKW

DATE 01/30/2026

SHEET NUMBER

E0.1

ISSUED FOR BID
NOT FOR CONSTRUCTION
01/30/2026

SHEET: 13 of 15

© Copyright 2026 DuBois & King Inc.

ISSUED FOR BID
NOT FOR CONSTRUCTION
01/30/2026

REVISIONS	REVISION DESCRIPTION
1	02/10/20 ADDENDUM #1


CLIENT NAME:
BURLINGTON BEER COMPANY

PROJECT NAME:
BBCO
Wastewater
Pretreatment
25 OMEGA DRIVE
WILLISTON, VT 05495

SHEET TITLE:
FIRST FLOOR PLAN -
POWER


D&K PROJECT #	PROJ. ENG.
530759	SMP
CHECKED BY	DRAWN BY
SMP	JKW
DATE	01/30/2026
SHEET NUMBER	

E1.1

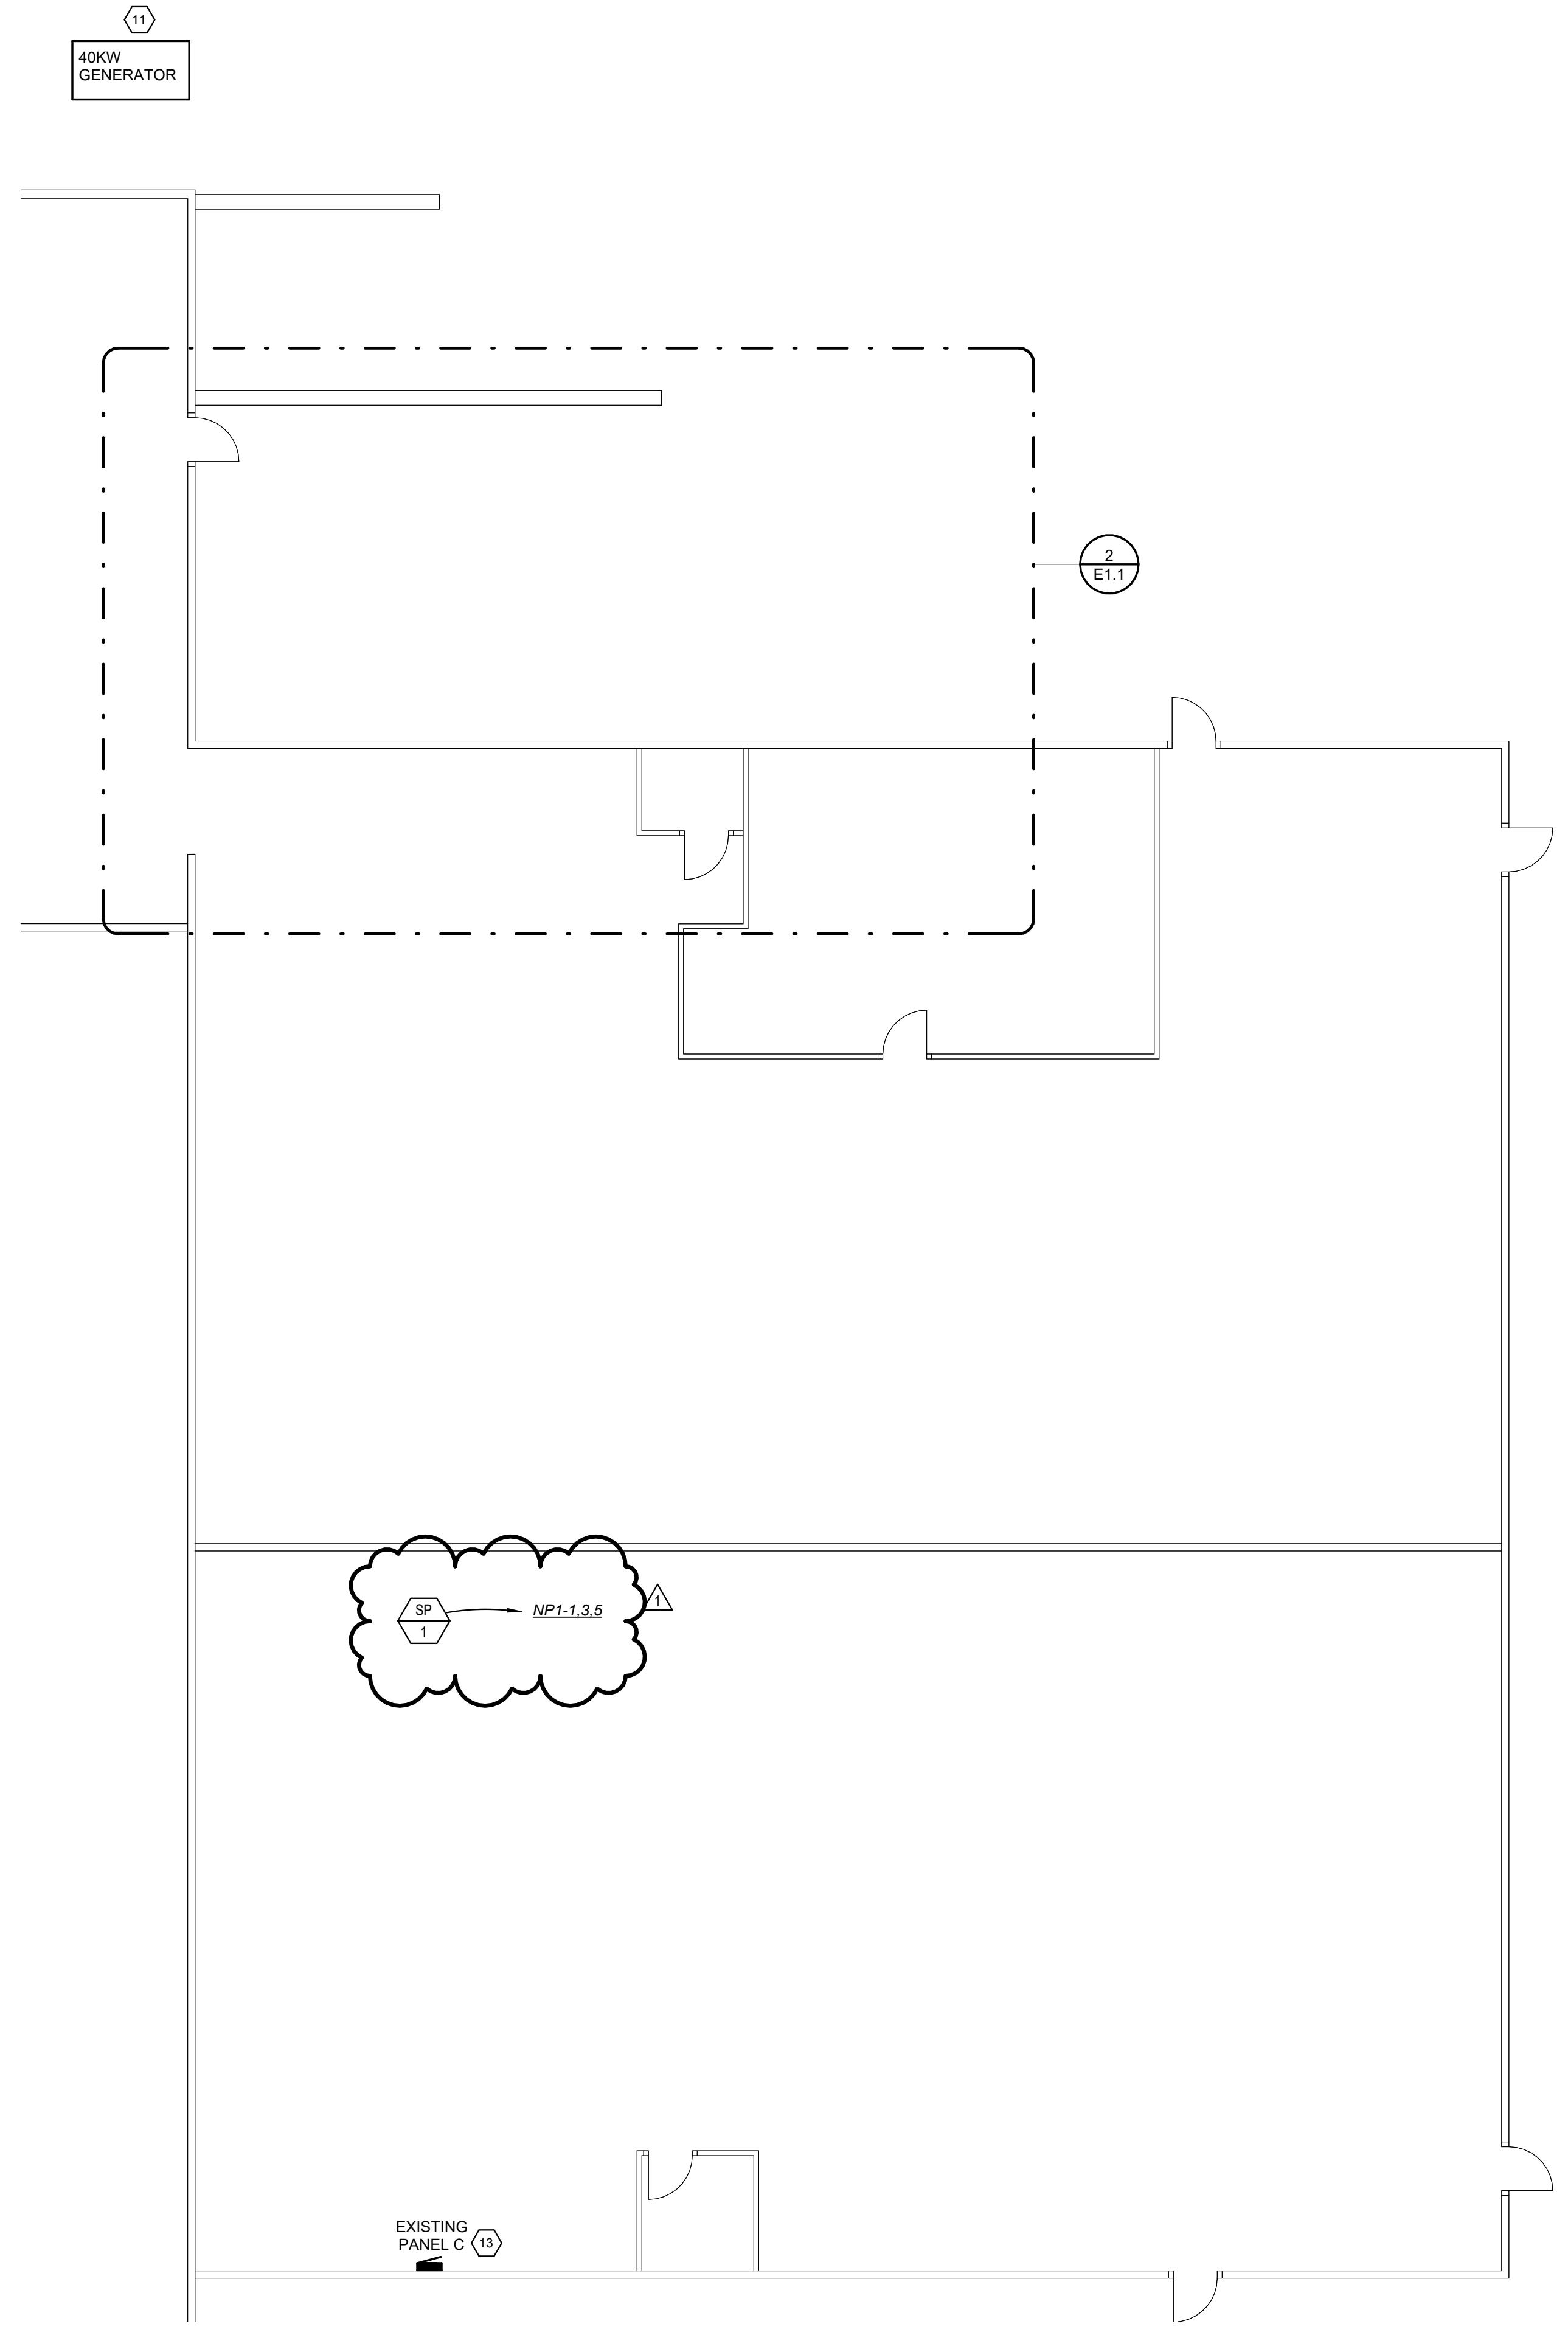

EQUIPMENT TAG	HP	AMPS (MCA)	VOLT	PHASE	DEVICE	PANEL CIRCUIT No.	CIRCUIT BREAKER				BRANCH CIRCUIT	REMARKS
							AMP	POLE	GF	ST		
P101	1/2	-	120	1	PROVIDE FUSED DISCONNECT		15.00	1			2#12, 1#12, 3/4" C	FED VIA CP101
P102	1/2	-	120	1	PROVIDE FUSED DISCONNECT		15.00	1			2#12, 1#12, 3/4" C	FED VIA CP101
AB101	2	-	208	3	PROVIDE FUSED DISCONNECT		20.00	3			3#12, 1#12, 3/4" C	FED VIA MCC101
P201	1	-	208	3	PROVIDE WP FUSED DISCONNECT		20.00	3			3#12, 1#12, 3/4" C	FED VIA MCC101
P301	1/2	-	208	3	PROVIDE WP FUSED DISCONNECT		20.00	3			3#12, 1#12, 3/4" C	FED VIA CP201
P302	1/2	-	208	3	PROVIDE WP FUSED DISCONNECT		20.00	3			3#12, 1#12, 3/4" C	FED VIA CP201
JA301	3	-	208	3	PROVIDE WP FUSED DISCONNECT		20.00	3			3#12, 1#12, 3/4" C	FED VIA CP201
JA201	16	-	208	3	PROVIDE WP FUSED DISCONNECT		80.00	3			3#5, 1#8, 1" C	FED VIA CP201
SP-1	2.00	-	208	3	PROVIDE DISCONNECT		15.00	3			3#12, 1#12, 3/4" C	

GENERAL SHEET NOTES	
1. ALL WIRING ON THE EXTERIOR OF THE BUILDING SHALL BE WITHIN PVC COATED RIGID STEEL CONDUITS, OR U.L. LISTED ALUMINUM. ALL ELECTRICAL PANELS, DISCONNECT SWITCHES, PULL BOXES, J-BOXES, ETC SHALL BE PROVIDED WITH CORROSION RESISTANT METAL CONSTRUCTION RATED FOR ASBESTOS CEMENT COATED UNLESS OTHERWISE NOTED HEREIN OR IN THE SPECIFICATION. ALL CONDUIT HANGING HARDWARE SHALL BE PROVIDED WITH NEMA 4X STAINLESS STEEL CONSTRUCTION. PROVIDE CABLE AND CONDUIT SEALOFF FITTINGS AT ALL TERMINATIONS IN ACCORDANCE TO NEC 501.	
10 CONTROL PANEL MCC201 FURNISHED BY ENEREAU, INSTALLED BY PLUMBING CONTRACTOR, AND WIRED BY ELECTRICAL CONTRACTOR. COORDINATE FINAL LOCATION WITH PLUMBING CONTRACTOR.	
11 PROPOSED LOCATION FOR THE NEW PORTABLE 40kW GENERATOR. GENERATOR IS TO BE GENERAC MMG50F4 OR EQUIVALENT.	
12 NEW 100A SURFACE MOUNTED PANEL NP-1 TO PROVIDE POWER FOR TREATMENT SYSTEM.	
13 PROVIDE A 100A 3P BREAKER IN PANEL C FOR NEW PANEL NP-1.	
14 120V 12 40A HEAT TRACE CONTROL PANEL. PROVIDE 285' 1#16G-3/4" C FROM EXISTING PANEL C. COORDINATE FINAL LOCATION AND REQUIREMENTS WITH PLUMBING CONTRACTOR.	
15 EO TO TERMINATE AND TEST ALL CABLES AND JACKS. CABLES SHALL RUN BACK TO NETWORK CLOSET. COORDINATE LOCATIONS WITH OWNER.	
16 PROVIDE 2#18, 3/4" C FROM LEVEL SENSOR LS101 TO CP101. FIELD COORDINATE ACTUAL EQUIPMENT LOCATIONS AND CONDUIT TERMINATION LOCATIONS WITH THE PUMP CONTROL SYSTEM EQUIPMENT INSTALLER PRIOR TO ROUGHING IN.	

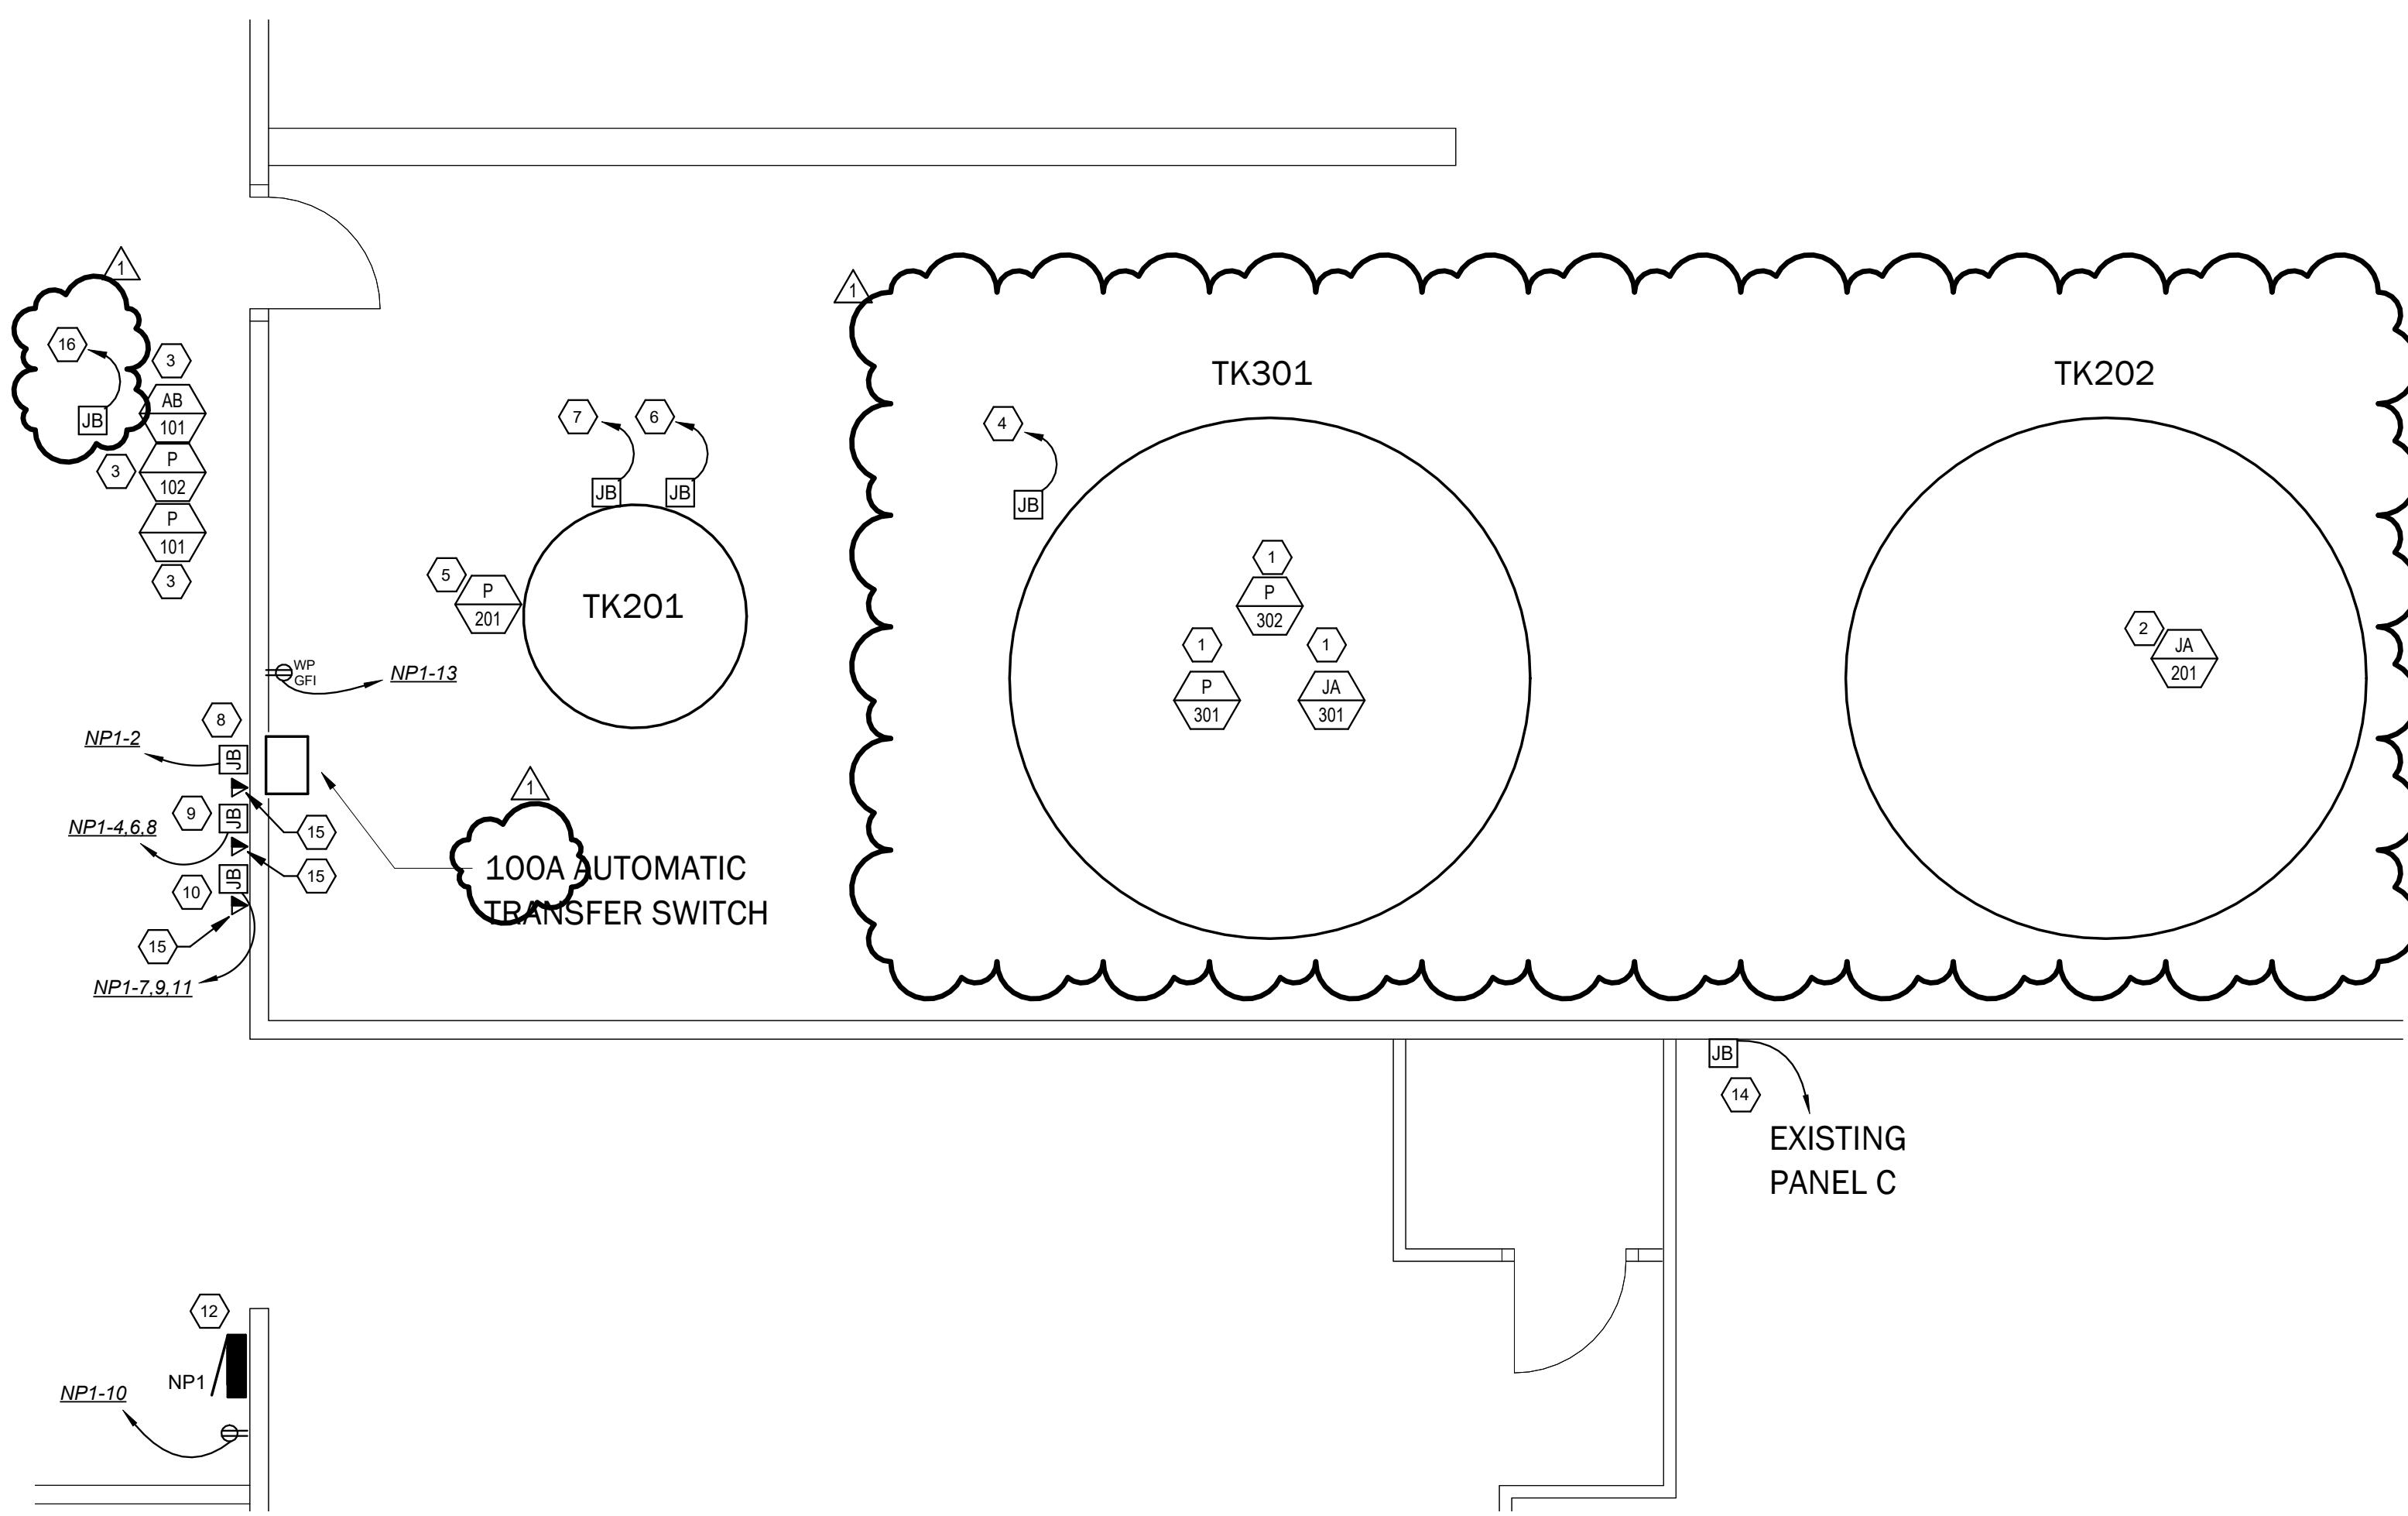

ISSUED FOR BID
NOT FOR
CONSTRUCTION
01/30/2026

REVISIONS	REVISION DESCRIPTION	BY
1	02/10/20 ADDENDUM #1	26

CLIENT NAME:
BURLINGTON BEER COMPANY

PROJECT NAME:
BBCO
Wastewater
Pretreatment
25 OMEGA DRIVE
WILLISTON, VT 05495


SHEET TITLE:
ELECTRICAL
SCHEDULES &
DETAILS

D&K PROJECT #	PROJ. ENG.
530759	SMP
CHECKED BY	DRAWN BY
SMP	JKW

DATE
01/30/2026

SHEET NUMBER
E6.1

SHEET: 15 of 15


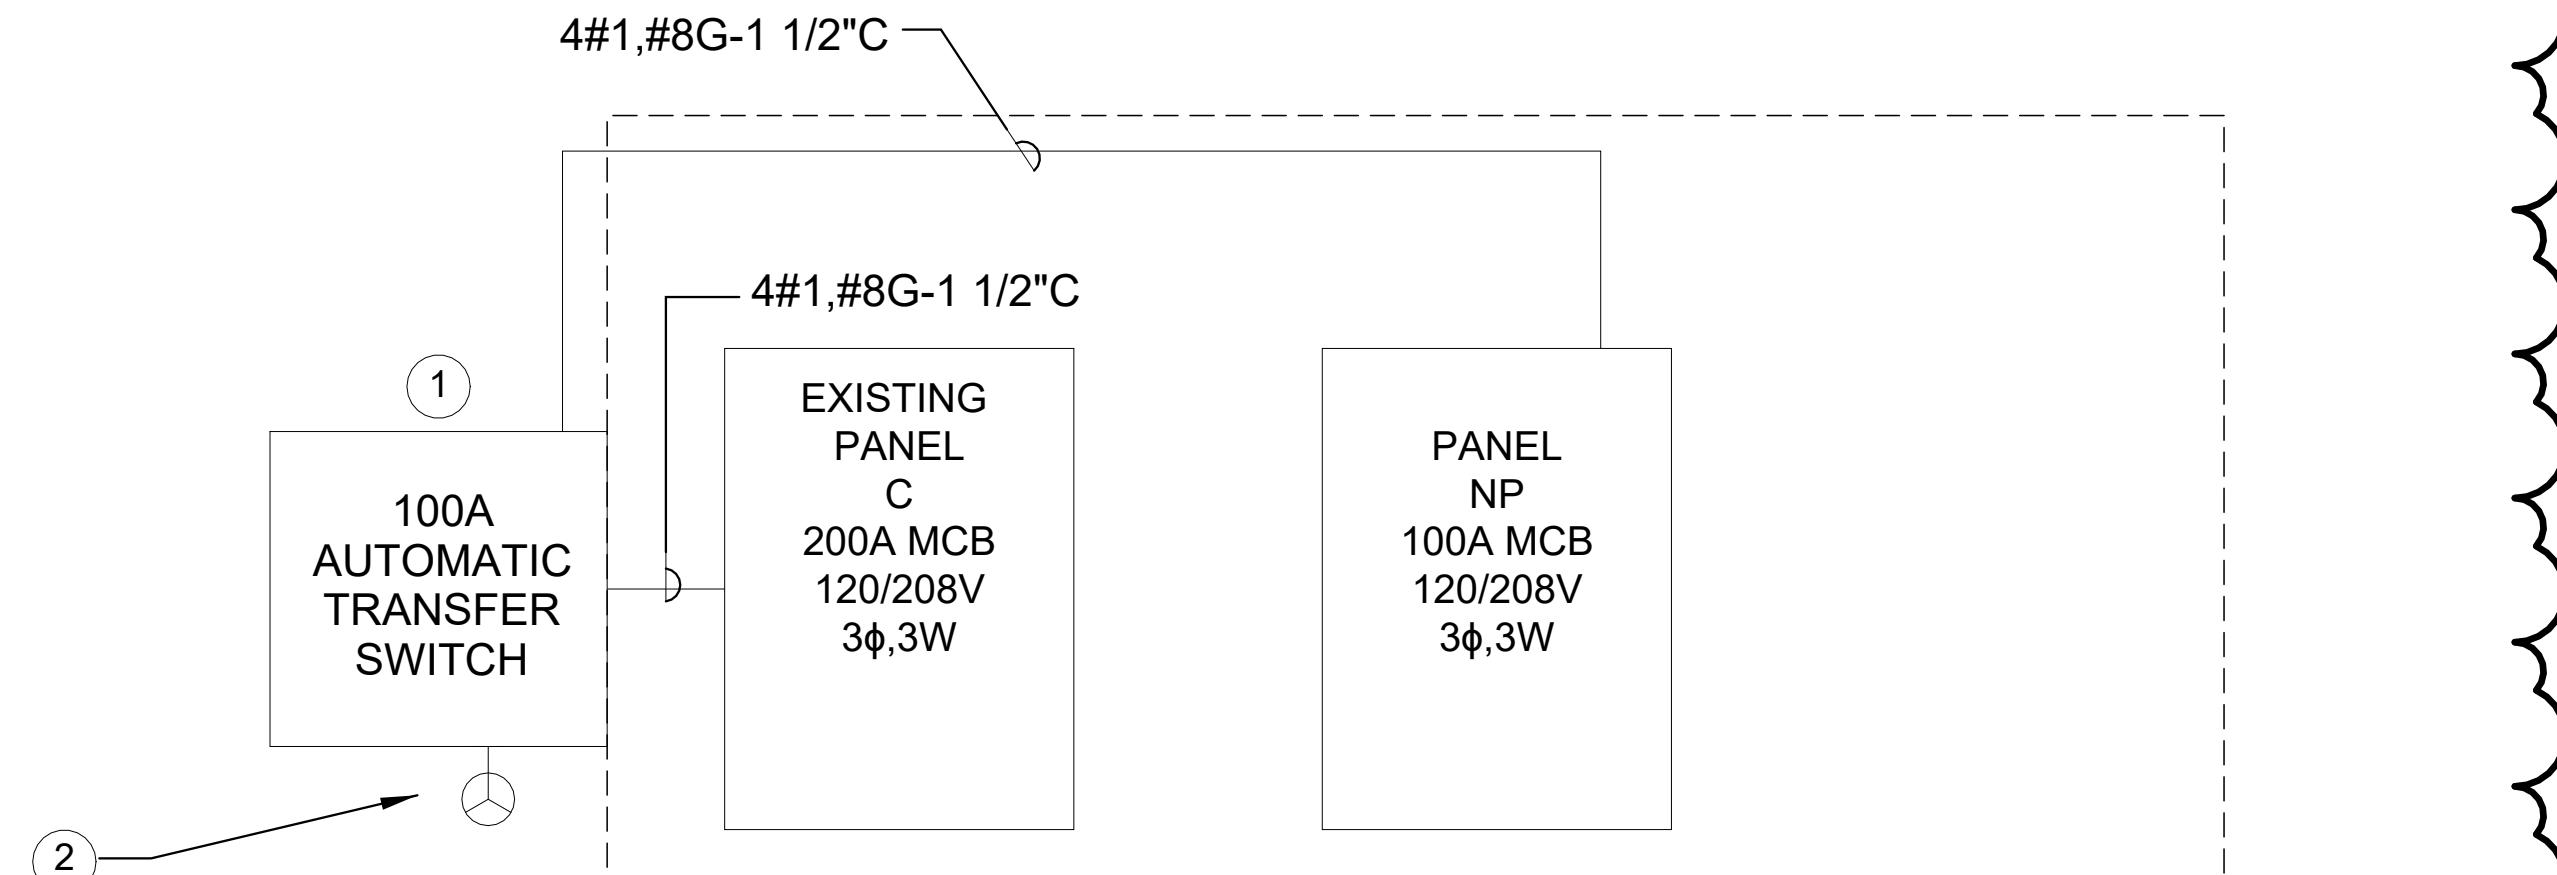


ELECTRIC RISER

N.T.S.

ELECTRIC RISER KEYNOTES 'O'

1. PROVIDE NEMA 3R RATED ENCLOSURE FOR MANUAL TRANSFER SWITCH. 100A 4P 208V 3 PHASE EQUAL TO ASCO SERIES 300.
2. PROVIDE CONNECTION FOR PORTABLE GENERATOR; VERIFY PROPER CORD AND RECEPTACLE CONFIGURATION WITH OWNER. 100A 4P 208V 3 PHASE PIN AND SLEEVE WATERTIGHT RECEPTACLE EQUAL TO HUBBELL HEAVY DUTY INDUSTRIAL GRADE ANGLED DOWN.

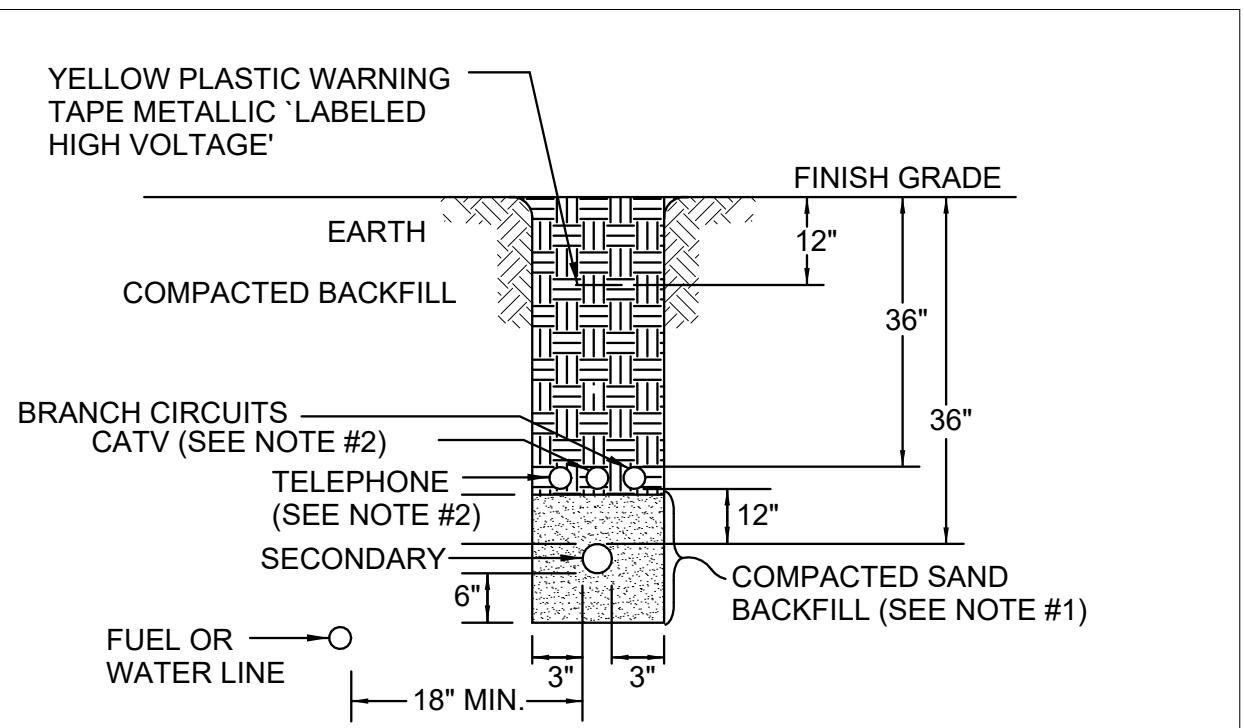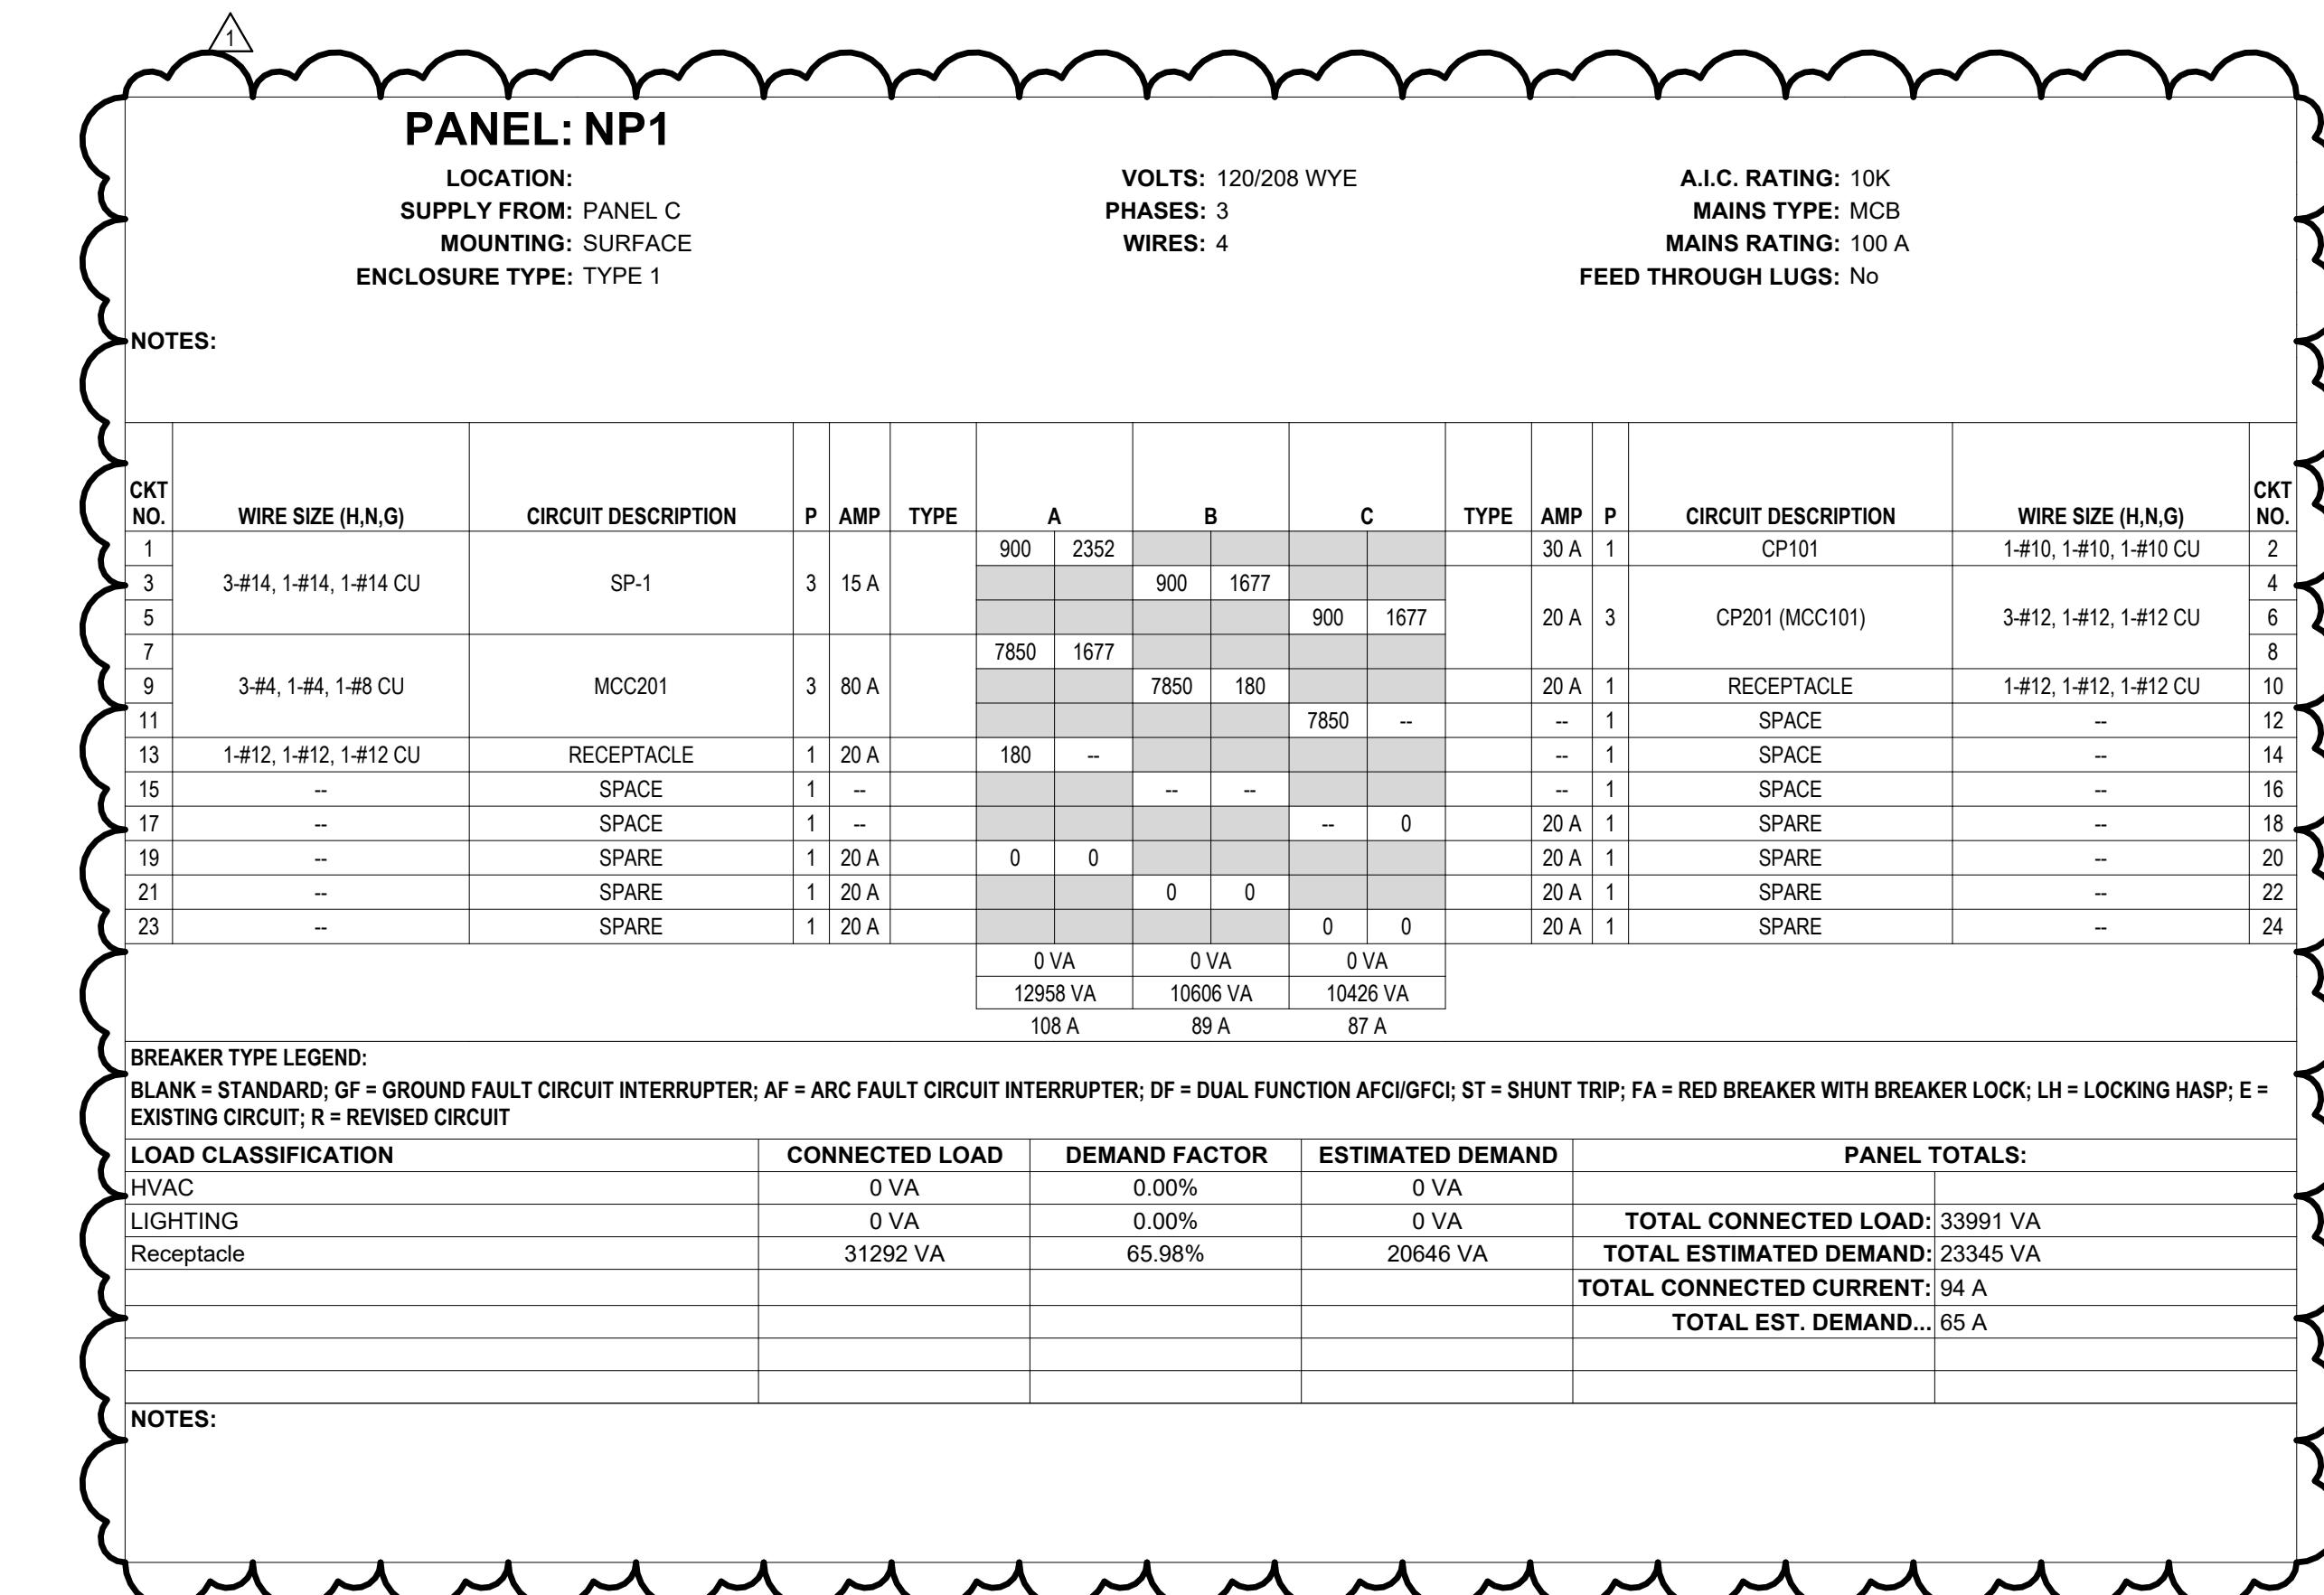


NOTES:

1. SELECT SAND BACKFILL SHALL CONSIST OF FINE GRANULAR MATERIAL OF WHICH 100% SHALL PASS THROUGH A 1/4" SIEVE. BACKFILL SHALL BE THOROUGHLY COMPAKTED IN 6 INCH LAYERS.
2. TELEPHONE, CATV AND FIRE ALARM CONDUITS MAY RUN IN THE SAME TRENCH AS ELECTRIC SERVICE CONDUITS AND/OR BRANCH CIRCUIT CONDUITS PROVIDING A MINIMUM OF 12 INCH HORIZONTAL SEPARATION IS MAINTAINED. IF RUN IN THE SAME TRENCH AS PRIMARY CONDUITS A MINIMUM OF 12 INCHES BOTH HORIZONTAL AND VERTICAL SEPARATION SHALL BE MAINTAINED. SEE NOTE #1 ABOVE.
3. ALL CONDUIT BENDS OF 45 DEGREE OR MORE SHALL BE GALVANIZED RIGID STEEL. THE FIRST 10 FOOT SECTION OF CONDUIT BOTH HORIZONTAL AND VERTICAL AT UTILITY POLES, TRANSFORMER PADS AND AT BUILDING CONDUIT ENTRANCES, SHALL BE GALVANIZED RIGID STEEL. PROVIDE 3/8" NYLON PULL ROPE IN ALL EMPTY CONDUITS.
4. ALL NONMETALLIC CONDUIT AND FITTINGS SHALL BE ELECTRICAL GRADE, SCHEDULE 80 PVC AND SHALL CONFORM TO THE APPLICABLE SECTIONS OF NEMA TC2-1990 AND BE UL LISTED. ONLY GRAY COLORED CONDUIT WILL BE ACCEPTED. ANY PVC CONDUIT NOT HAVING THE PROPER NEMA OR UL MARKINGS WILL NOT BE ACCEPTED. ALL STEEL CONDUITS SHALL CONFORM TO ASTM A120 AND BE RIGID GALVANIZED STEEL. ALL PVC CONDUITS MUST BE CEMENTED. STEEL FITTINGS SHALL BE SEALED WITH COMPOUND.
5. ALL CONDUIT SYSTEMS, SHOWN ON THIS DETAIL, MAY NOT BE PRESENT ON THIS PROJECT. THIS IS A TYPICAL CONDUIT TRENCH DETAIL, EACH INDIVIDUAL PROJECT MAY HAVE MORE OR LESS CONDUIT SYSTEMS.

TYPICAL CONDUIT TRENCH DETAIL SECTION

N.T.S.

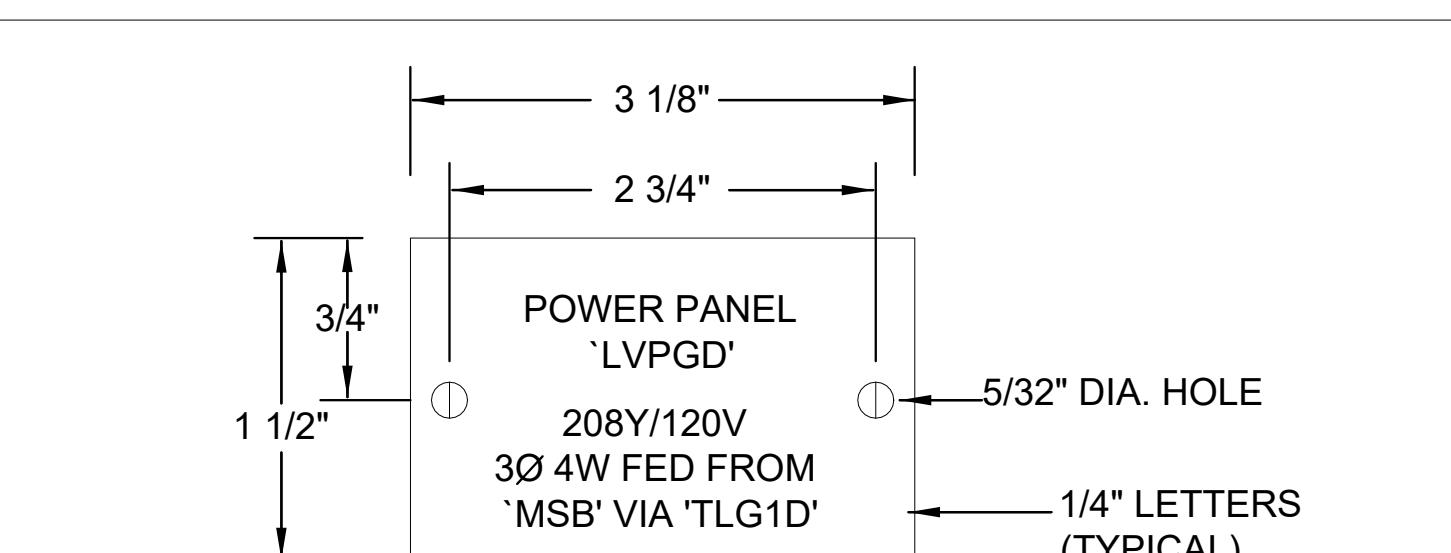

1. REFER TO SPECIFICATIONS FOR ADDITIONAL NAMEPLATE REQUIREMENTS.
2. NAMEPLATE TO 1/16" PLASTIC WITH CENTER LAMINATION.
3. SECURE NAMEPLATE TO SURFACES WITH (2) FLAT HEAD BRASS SCREWS. .
4. 208Y/120 VOLT PANELBOARDS SHALL HAVE BLUE FACE PLATES WITH WHITE ENGRAVED LETTERS, UNLESS OTHERWISE NOTED.
5. 480Y/277 VOLT PANELBOARDS SHALL HAVE ORANGE FACE PLATES WITH BLACK ENGRAVED LETTERS., UNLESS OTHERWISE NOTED.
6. PANELS FED FROM THE EMERGENCY GENERATOR SYSTEM SHALL HAVE RED FACEPLATES WITH WHITE ENGRAVED LETTERS.

TYPICAL NAMEPLATE DETAIL

N.T.S.

ISSUED FOR BID
NOT FOR CONSTRUCTION
01/30/2026